
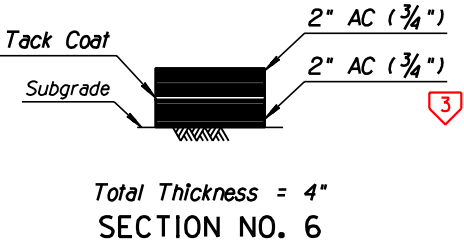
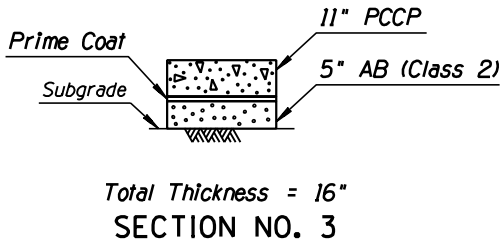
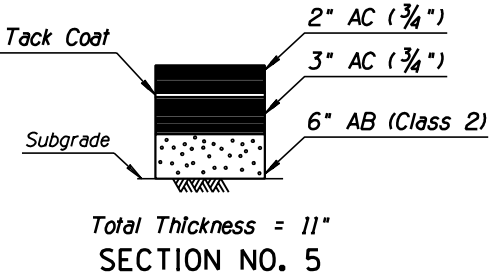
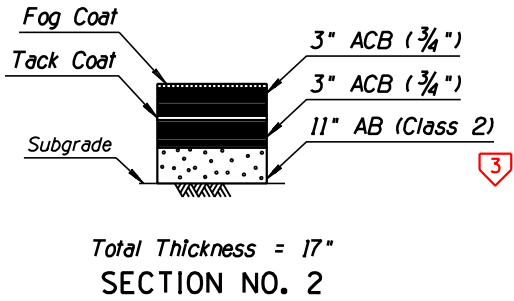
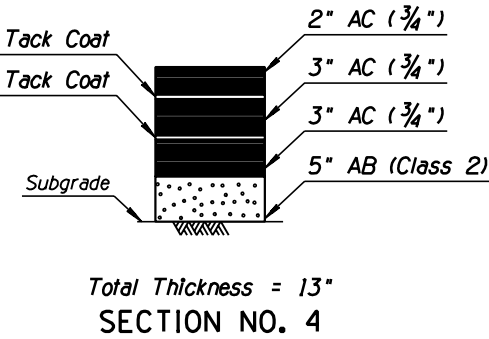


F.H.W.A. REGION	STATE	PROJECT NO.	SHEET NO.	TOTAL SHEETS	AS BUILT
9	ARIZ.	RAM-600-1-501	3	541	

101L MA 52

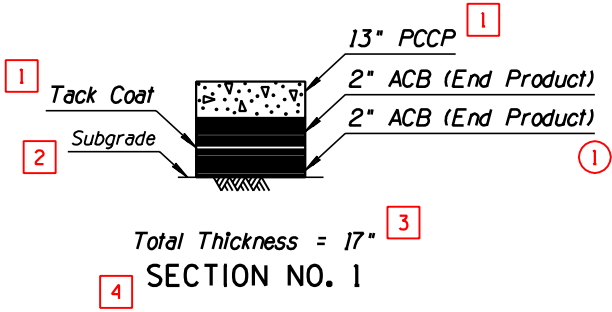

PAVEMENT STRUCTURAL SECTIONS

	NAME	DATE	ARIZONA DEPARTMENT OF TRANSPORTATION HIGHWAYS DIVISION HIGHWAY PLANS SERVICES		
DESIGN	T MACBETH	10-90			
DRAWN	M HAUER	10-90			
CHECKED	R DELANO	12-90			
TEAM LEADER	J BRUBAKER		DESIGN SHEET PAVEMENT STRUCTURAL SECTIONS		
ROUTE	LOCATION	PRICE, FIRST ST - BASELINE			SHEET 2 OF 4
SR 101L					

TRACS NO. H0000 01 C

OF